


SKICA

SNIMKA IZVEDENOG STANJA
TLOCRT PODRUMA

ŠKALA

1:100



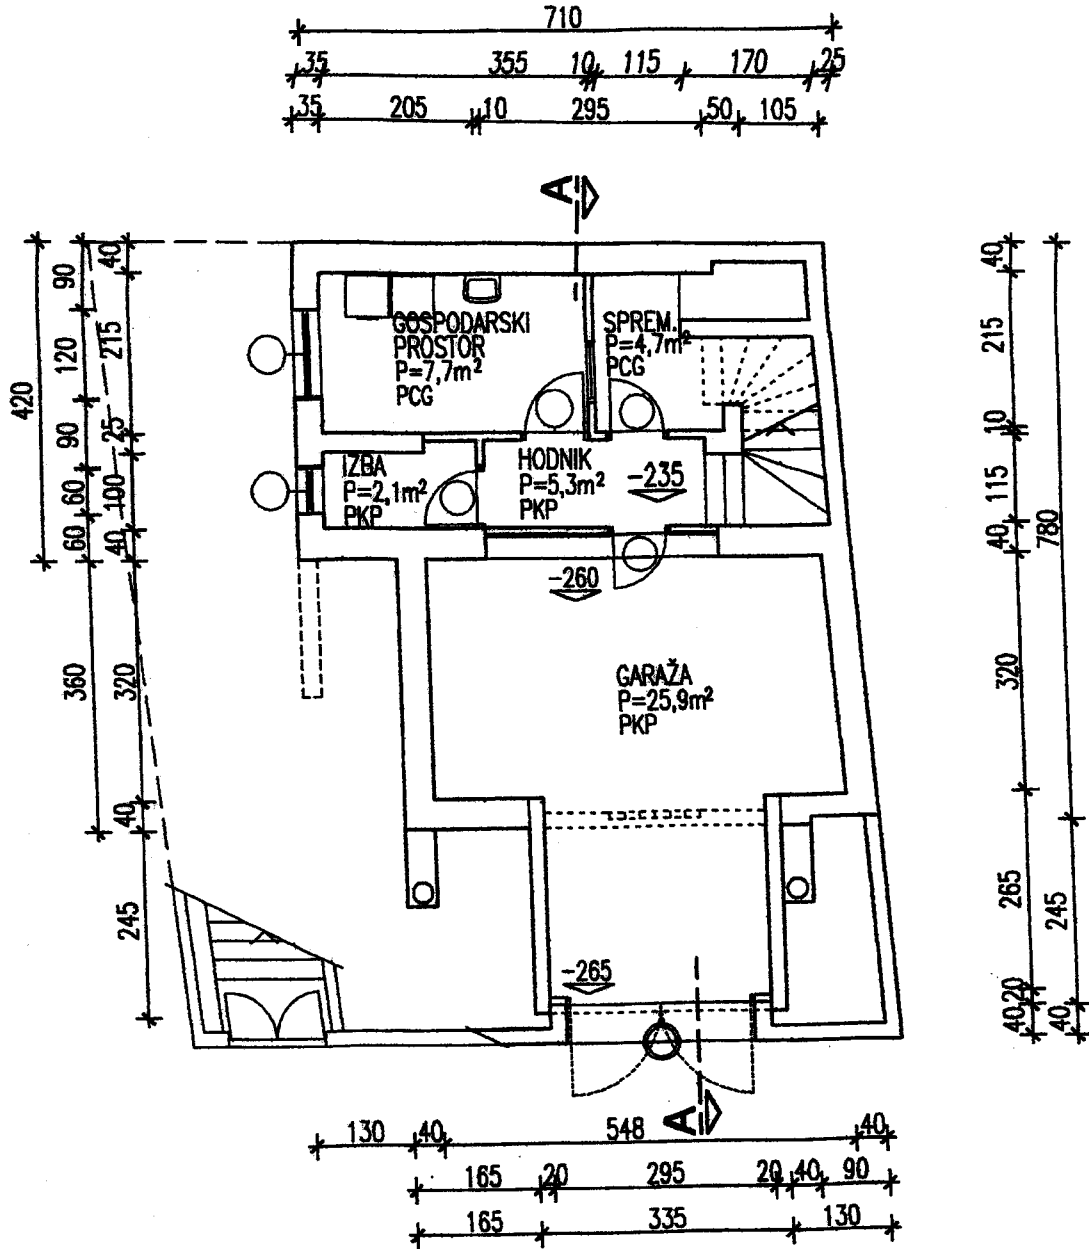


BRZDAJ

SNIMKA IZVEDENOG STANJA
TLOCRT PRIZEMLJA

MJERLO

1:100

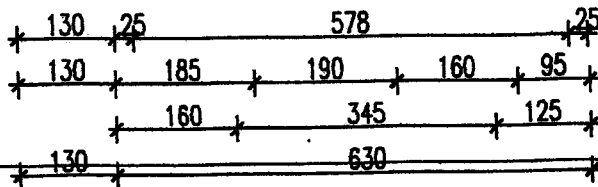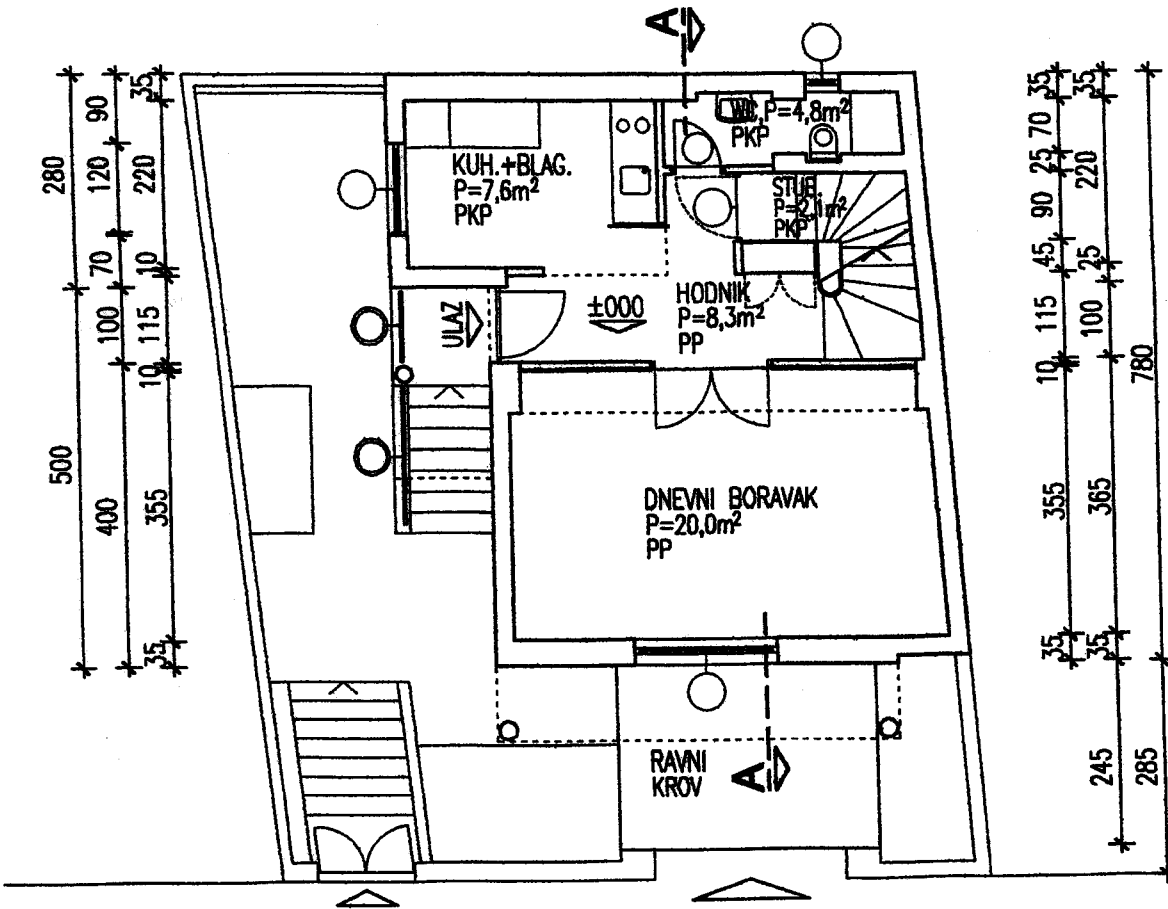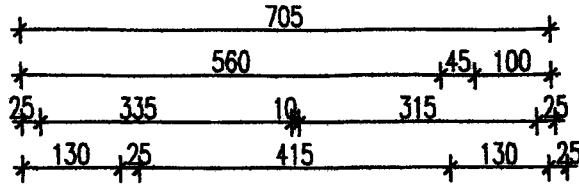


BADRŽAJ

SNIMKA IZVEDENOG STANJA
TLOCRT 1. KATA

MERILLO

1:100

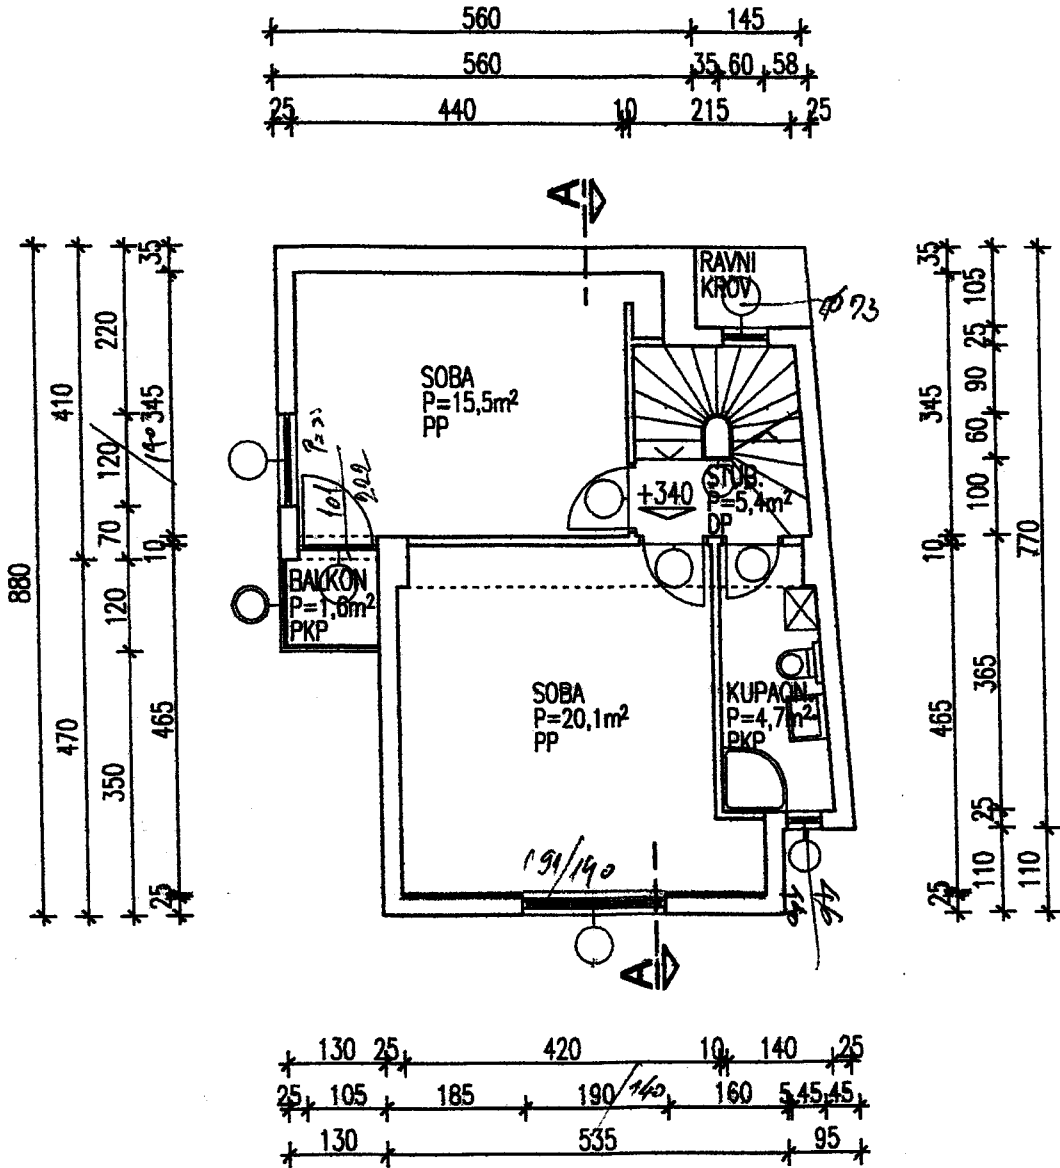

BRANJA

SNIMKA IZVEDENOG STANJA
TLOCRT POTKROVLJA

MERNO

1:100

